

ATLANTIC YARDS CONSTRUCTION UPDATE  
SUPPLEMENTAL REPORT


This is a Supplemental Report to the previously issued two week look – ahead regarding upcoming construction activities at Atlantic Yards covering the period of August 15 – August 28, 2011

The following section has been modified to include new information:

**Utilities**

- The proposed temporary revisions to the Dean Street 16’ high fence are marked in red on the attached sketch.
- The excavation work required to complete the sanitary/storm Point of Entry (POE) 5 and the water service to the arena require the temporary removal of approximately 40’ to 60’ of the 16 foot high fence on Dean Street. A temporary 8 foot tall barrier consisting of plywood on Jersey barrier will be installed to replace the 16’ fence and to serve as the construction fence during the work. The contractor will move the barrier out of the way when trenching occurs in the immediate area and will plate over and replace the barrier on a daily basis.
- It is possible that portions of this Work will be constructed during second and/or third shift.
- The primary reasons are:
  - The 16’ high fence cannot be safely moved in and out of place on a daily basis to accommodate the Work. It is too high and too heavy and is subject to wind load.
  - The excavation for the water and sewer piping will require a 25 foot deep trench extending from the face of the foundation to the Dean Street centerline including an area underneath the 16’ high fence and its supports.
- The MPT plan for this work was approved by OCMC on July 25, 2011 and is attached to this update. The MPT displaces a portion of the bicycle lane. Temporary traffic controls signage will be provided to alert bicycles and vehicles to “share the road”. Some parking on the south side of Dean Street will be removed for the duration of the work.
- The duration for the temporary 8’ high fence is projected to be 30-45 calendar days, subject to weather impacts, unknown conditions and the permitting/inspection process for the Work to be done.
- The 16’ high fence will be reinstalled upon completion of all of the piping installation.

FILE NAME = N:\2009 ARENA REVIVAL\cadd\plot sheets\mpt\dean-st\_uti-poe-mpt\_pln.dwg  
 DATE/TIME = Jul 25, 2011 - 11:42am

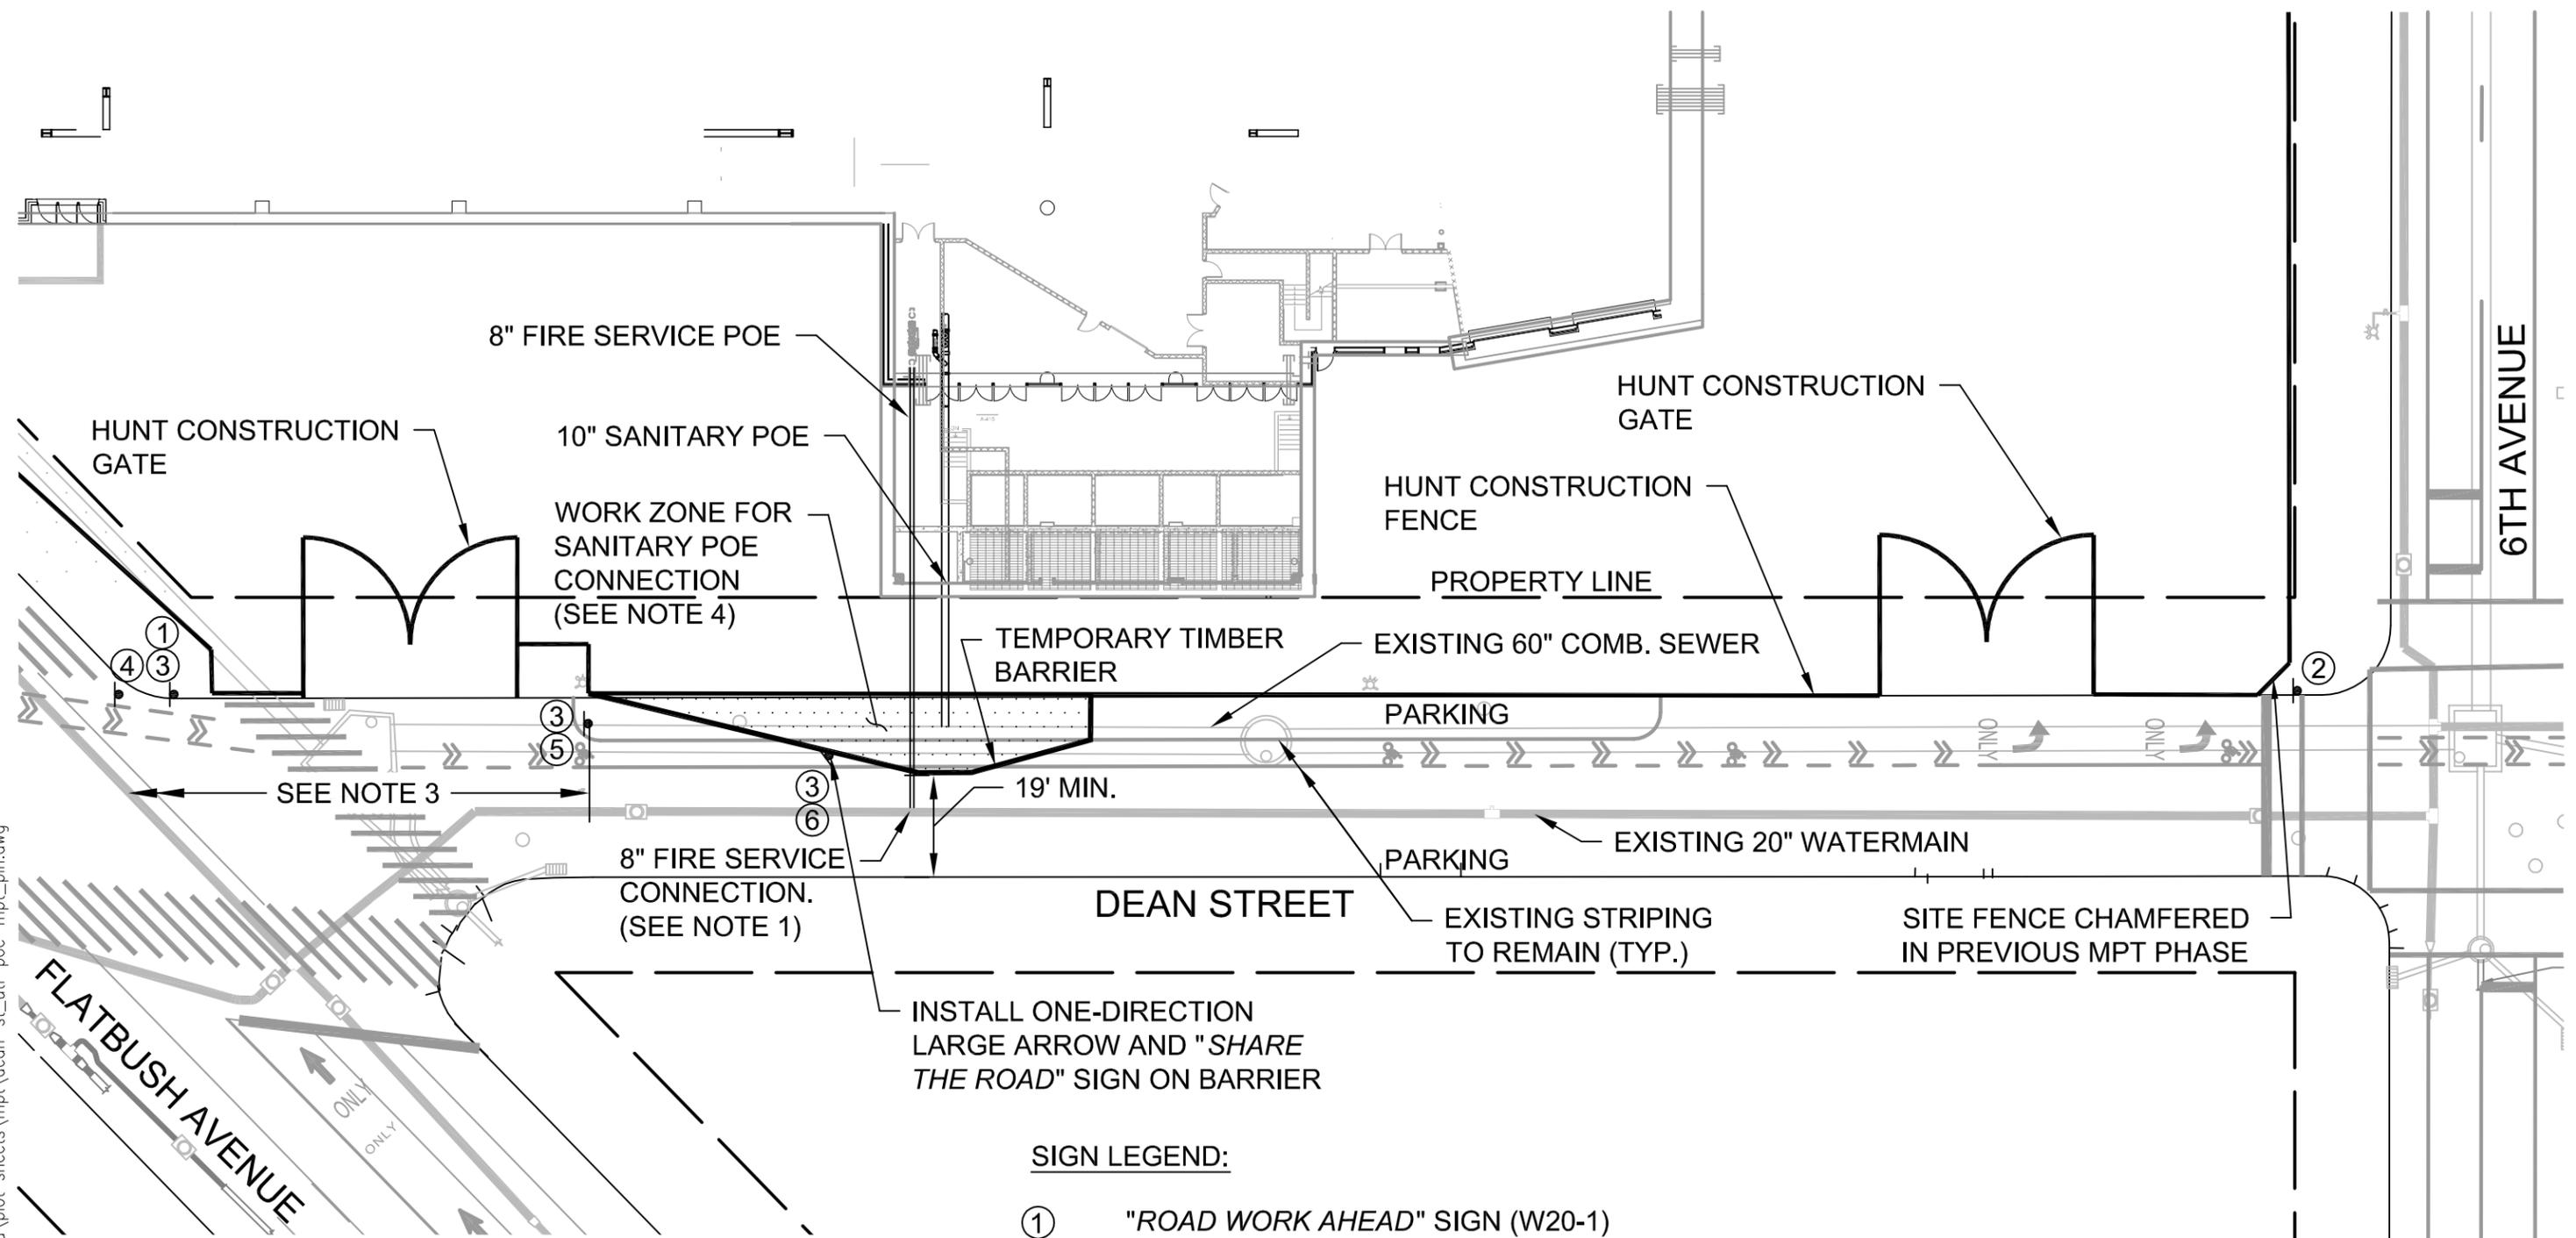

**NOTES:**  
 1. 8" FIRE SERVICE CONNECTION SHALL BE INSTALLED AT NIGHT. PLATE UTILITY TRENCH DURING DAYTIME HOURS UNTIL COMPLETION.  
 2. TEMPORARY TRAFFIC CONTROL SIGNS TO BE BLACK ON ORANGE SIGN COLOR  
 3. INSTALL "CONSTRUCTION IN BIKE LANE AHEAD PROCEED WITH CAUTION" SIGNS 350' AND 200' PRIOR TO WORK ZONE ON DEAN STREET SIDEWALK BETWEEN 5TH AND FLATBUSH AVE.  
 4. CONTRACTOR TO RE-STRIPE BIKE LANE AND PARKING LANE AS REQUIRED FROM WORK ZONE DISTURBANCE.

**SIGN LEGEND:**

- ① "ROAD WORK AHEAD" SIGN (W20-1)
- ② "END ROAD WORK" SIGN (G20-2)
- ③ ONE-DIRECTION LARGE ARROW SIGN (W1-6R)
- ④ "CONSTRUCTION IN BIKE LANE AHEAD PROCEED WITH CAUTION" SIGN (SC-85)
- ⑤ "CONSTRUCTION IN BIKE LANE PROCEED WITH CAUTION" SIGN (SC-84)
- ⑥ "SHARE THE ROAD" SIGN (SW-675)

**DEAN STREET POE CONNECTION MPT PLAN**

SCALE: 1"=10'  
 DATE: 07-25-2011


  
 50 WEST 23RD STREET  
 NEW YORK, NY 10010-5205  
 TEL. 212-366-5600  
 FAX 212-366-5629

**PROPOSED 16' FENCE AMENDMENT AT DEAN STREET**

**POE 5 SEWER &  
WATER  
CONNECTIONS**

**Section of 16'  
fence to be  
removed for POE  
excavation (40 to  
60 feet)**

**Approx. Dean  
Street Fence  
Location**

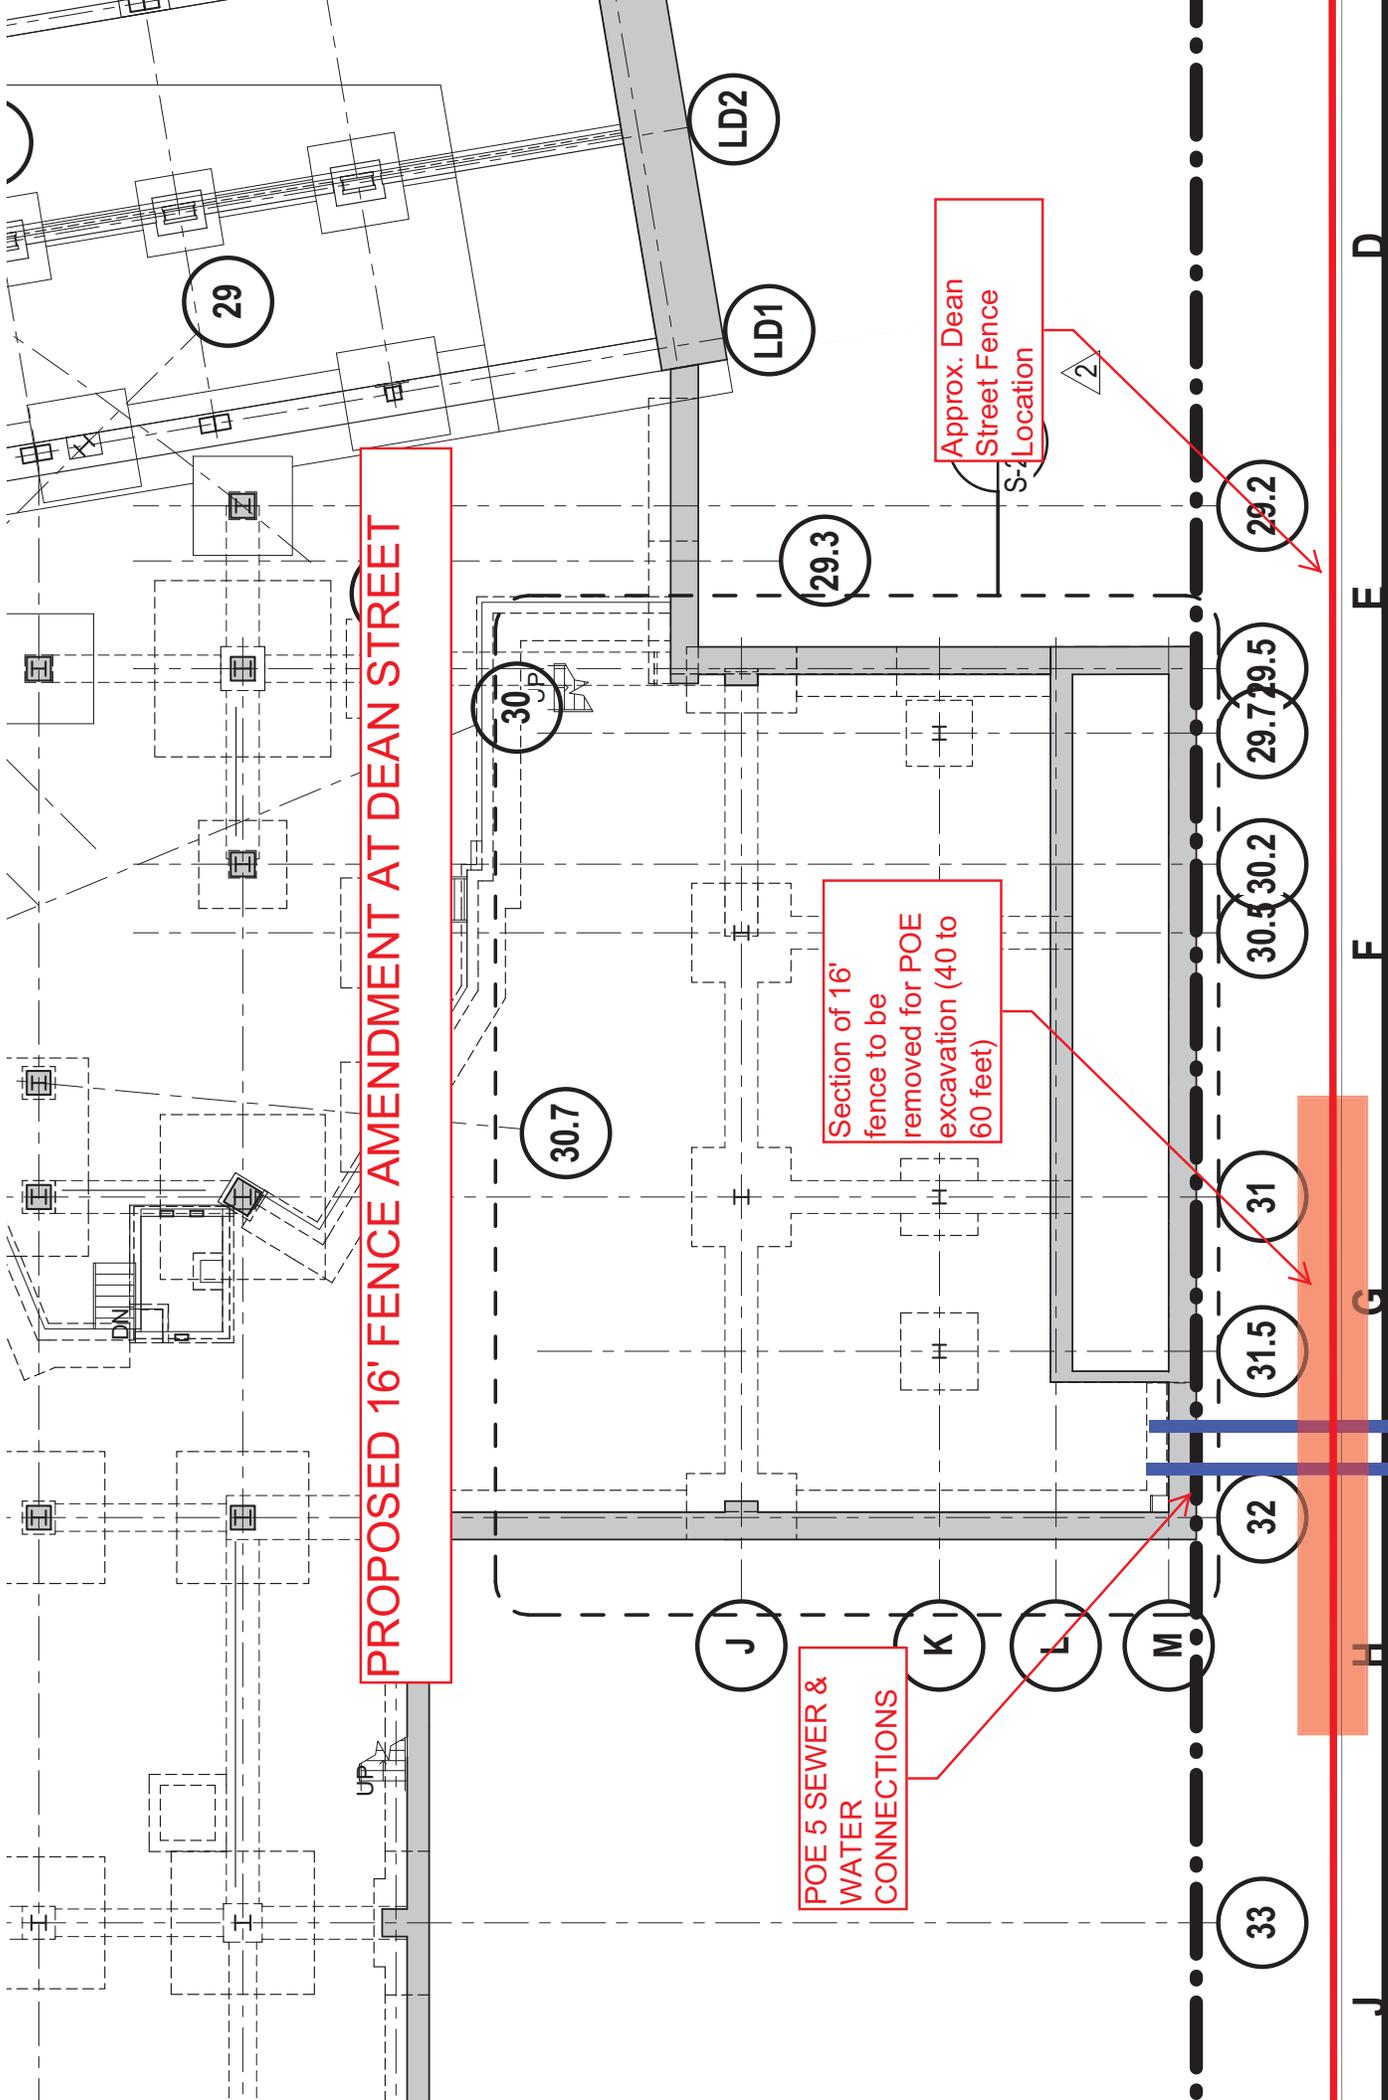

J D  
F  
F  
G  
H  
J